

# Alberta Free-mo 2024

August 15 - 18, 2024  
Big Valley Alberta


AFM24\_As Built\_240820

Public Entrance

Boards / Player's Benches

100 FT

100 FT

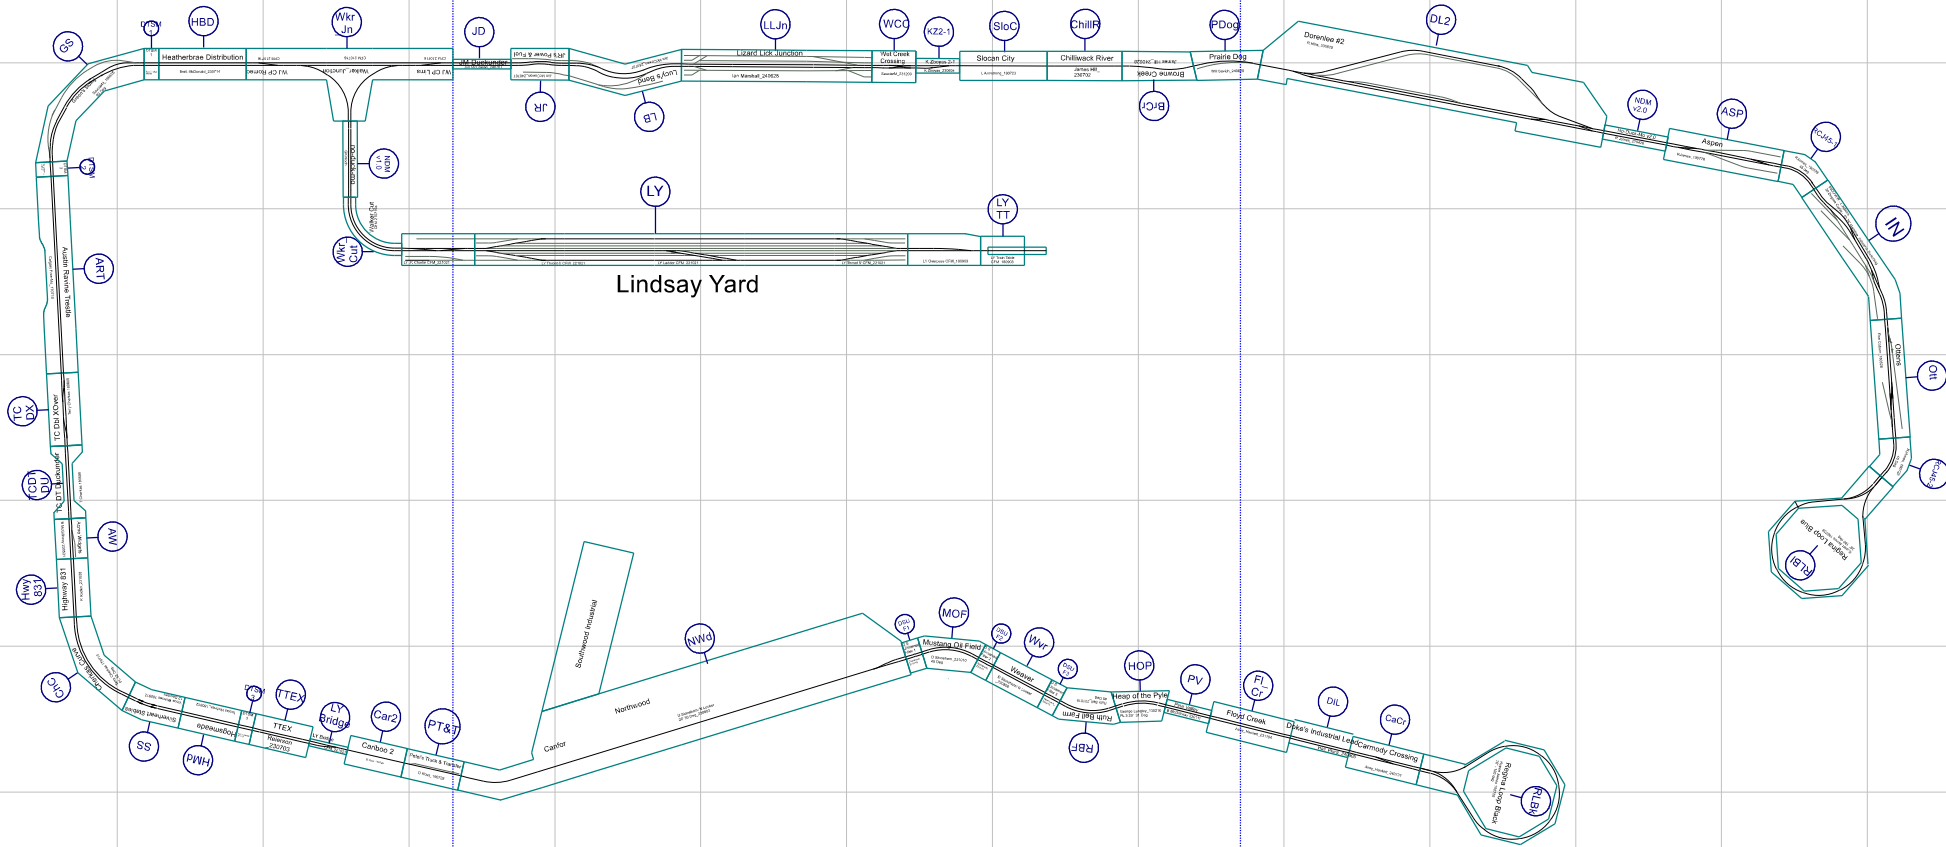

10 Foot Grid

## Stands

**Dorelee Subdivision**  
 JM Duckunder  
 JR's Power & Fuel  
 Lucy's Bend  
 Lizard Lick Junction  
 Wet Creek Crossing  
 KZ 2-1  
 Slocan City  
 Chilliwack River  
 Browne Creek  
 Prairie Dog

**Walker Subdivision**  
 Walker Junction  
 NoDuckMo V1.0  
 Walker Cut  
 Lindsay Yard  
 Train Table

## Cherkas Subdivision (Signalled)

Heatherbrae Junction  
 Double Track Signal-Mo 1  
 Green's Siding  
 Double Track Signal-Mo 2  
 Austin Ravine Trestle  
 TC Double Crossover  
 TC Double Track Duckunder

## Northwood Subdivision

TTEX  
 Lindsay Bridge  
 Cariboo 2  
 Petel's Truck & Transfer  
 Northwood  
 --Southwood Industrial  
 DS Filler 1  
 Mustang Oil Field  
 DS Filler 2  
 Weaver  
 DS Filler 3  
 Ruth Bell Farm  
 Heap Of the Pyle  
 Pine Valley  
 Doke's Industrial Lead  
 Floyd Creek  
 Carmody Crossing  
 Regina Loop Black

**Modules listed sequentially from Keystone**